

5:44 PM
07/14/04
Accrual Basis

Clepper-Faith 1st phase

Ordinary Income/Expense

Income

400 - Construction Revenue (Construction Income)

420 - Management Fees

Total Income

Cost of Goods Sold

01000 - GENERAL REQUIREMENTS

0700 - General Conditions

Jobsite Supervision

1043-S - Jobsite Supervision

Total Jobsite Supervision

1060 - Permits & Fees

1064 - Engineer Fees

1065 - Archit. Fees (1060)

1070 - Insurance (1070)

1400 - Quality Control (1400)

1500 - Misc. Matl

1505 - Misc. Labor

1510 - Temporary Electric (1510)

1515 - Job Site Toilet (1515)

1525 - Equipment Rentals (1525)

1540 - Scaffolding

1570 - Dumpster & Fees

1620 - Material Protection (1620)

1740 - Site Clean-up

1770 - Punch List

Total 01000 - GENERAL REQUIREMENTS

Insulation

7210-S - Insulation-Sub above ceiling

Total Insulation

90000 - FINISHES

Sheetrock

9250-M - Drywall-Matl

9250-S - Metal studs and Drywall-Subs

Total Sheetrock

Tile / Brick Finishes

9310-S - Ceramic Tile-Sub

Total Tile / Brick Finishes

Carpet

6115-M - Underlayment-Matl

VCT - tile

Rubber base

Epoxy Flooring

	Jan. 15, 09	Budget	\$ Over Budget
400 - Construction Revenue (Construction Income)	0.00	0.00	0.00
420 - Management Fees	0.00	0.00	0.00
Total Income	0.00	0.00	0.00
Cost of Goods Sold			
01000 - GENERAL REQUIREMENTS			
0700 - General Conditions	0.00	2,500.00	-2,500.00
Jobsite Supervision	0.00	0.00	0.00
1043-S - Jobsite Supervision	0.00	0.00	0.00
Total Jobsite Supervision	0.00	2,500.00	-2,500.00
1060 - Permits & Fees	0.00	1,200.00	-1,200.00
1064 - Engineer Fees	0.00	0.00	0.00
1065 - Archit. Fees (1060)	0.00	1,500.00	-1,500.00
1070 - Insurance (1070)	0.00	465.00	-465.00
1400 - Quality Control (1400)	0.00	0.00	0.00
1500 - Misc. Matl	0.00	200.00	-200.00
1505 - Misc. Labor	0.00	400.00	-400.00
1510 - Temporary Electric (1510)	0.00	0.00	0.00
1515 - Job Site Toilet (1515)	0.00	0.00	0.00
1525 - Equipment Rentals (1525)	0.00	0.00	0.00
1540 - Scaffolding	0.00	0.00	0.00
1570 - Dumpster & Fees	0.00	500.00	-500.00
1620 - Material Protection (1620)	0.00	0.00	0.00
1740 - Site Clean-up	0.00	350.00	-350.00
1770 - Punch List	0.00	75.00	-75.00
Total 01000 - GENERAL REQUIREMENTS	0.00	7,190.00	-7,190.00
Insulation			
7210-S - Insulation-Sub above ceiling	0.00	0.00	0.00
Total Insulation	0.00	0.00	0.00
90000 - FINISHES			
Sheetrock			
9250-M - Drywall-Matl	0.00	0.00	0.00
9250-S - Metal studs and Drywall-Subs	0.00	12,350.00	-12,350.00
Total Sheetrock	0.00	12,350.00	-12,350.00
Tile / Brick Finishes			
9310-S - Ceramic Tile-Sub	0.00	0.00	0.00
Total Tile / Brick Finishes	0.00	0.00	0.00
Carpet			
6115-M - Underlayment-Matl	0.00	0.00	0.00
VCT - tile	0.00	2,166.13	-2,166.13
Rubber base	0.00	486.00	-486.00
Epoxy Flooring	0.00	0.00	0.00

\$ 2500
+ signed lease

- paint & colors
- tile

- check in area
recept. mat

- Phase 1 muse station - armoire?

60-90 days
IT not included

Exam 6 - 2 doors?

HVAC - 2 thermostats
Elec. security 2 elec. notes

5:44 PM
07/14/04
Accrual Basis

9680-S - Carpet-Sub	0.00	0.00	0.00
Total Carpet	0.00	2,652.13	-2,652.13
Wood Flooring			
9640-L - Hardwood-Labor	0.00	0.00	0.00
9640-M - Hardwood-Matl	0.00	0.00	0.00
Total Wood Flooring	0.00	0.00	0.00
Painting			
9905-S-Ext. Paint labor	0.00	0.00	0.00
9905-M-Ext. Paint Mat.	0.00	0.00	0.00
9910-M-Int. Paint Mat.	0.00	5,410.00	-5,410.00
9910-S-Int. Paint labor	0.00	0.00	0.00
Total Painting	0.00	5,410.00	-5,410.00
Total 90000 - FINISHES	0.00	20,412.13	-20,412.13
10000 - SPECIALTIES			
Cyclone Fencing	0.00	0.00	0.00
10520 - S - Fire Extinguishers	0.00	0.00	0.00
Total 10000 - SPECIALTIES	0.00	0.00	0.00
11000 - EQUIPMENT			
	0.00	0.00	0.00
	0.00	0.00	0.00
Total 11000 - EQUIPMENT	0.00	0.00	0.00
12000 - FURNISHINGS			
Cabinets/Millwork (Cabinets & Tops)			
6410-S - Front desk allow.	0.00	4,000.00	-4,000.00
Break Room cab. Top and bottom		1,733.27	
Six exam room cab., bottoms only		4,314.90	
Six wall mounted cab.		2,664.51	
Window Treatment	0.00	0.00	0.00
Total 12000 - FURNISHINGS	0.00	12,712.68	-12,712.68
13000 - SPECIAL CONSTRUCTION			
13700 - Security System	0.00	0.00	0.00
13701 - Fire Alarm	0.00	0.00	0.00
10430 - Signage	0.00	200.00	-200.00
Specimen pass through (provide by tennant)			
Total 13000 - SPECIAL CONSTRUCTION	0.00	200.00	-200.00
15000 - MECHANICAL			
Mechanical-HVAC			
15700-S - Mechanical-Subs	0.00	500.00	-500.00
Total Mechanical-HVAC	0.00	500.00	-500.00
Plumbing			


2500 - 6000

5:44 PM
07/14/04
Accrual Basis

15400- S - Plumbing-Labor	0.00	1,697.00	-1,697.00
15401 - S - Fire Sprinkler System	0.00	0.00	0.00
15402 - S - Upgrade Water Supply for Sprinkler S	0.00	0.00	0.00
15400- S - Plumbing- 6" pipe from the street	0.00	0.00	0.00
Total Plumbing	0.00	1,697.00	-1,697.00
Total 15000 - PLUMBING - MECHANICAL	0.00	1,697.00	-1,697.00
16000 - ELECTRICAL			
16050-CO - Electrical-CO	0.00	0.00	0.00
16050-L - Electrical-Labor	0.00	0.00	0.00
16050-M - Fixture Allow.- Matl	0.00	0.00	0.00
16050-S - Electrical-Subs	0.00	7,125.00	-7,125.00
16220-S - Generator	0.00	0.00	0.00
16780-M-Stero / Television	0.00	0.00	0.00
Total 16000 - ELECTRICAL	0.00	7,125.00	-7,125.00
Total COGS		49,836.81	-49,836.81

table rounded wire

~~2550~~ 2550
~~2550~~ sq. ft @ \$16/sq ft = \$3400/month x 6 months
~~2550~~ @
 2250 x \$16/sq ft = 3000/month x 6 months

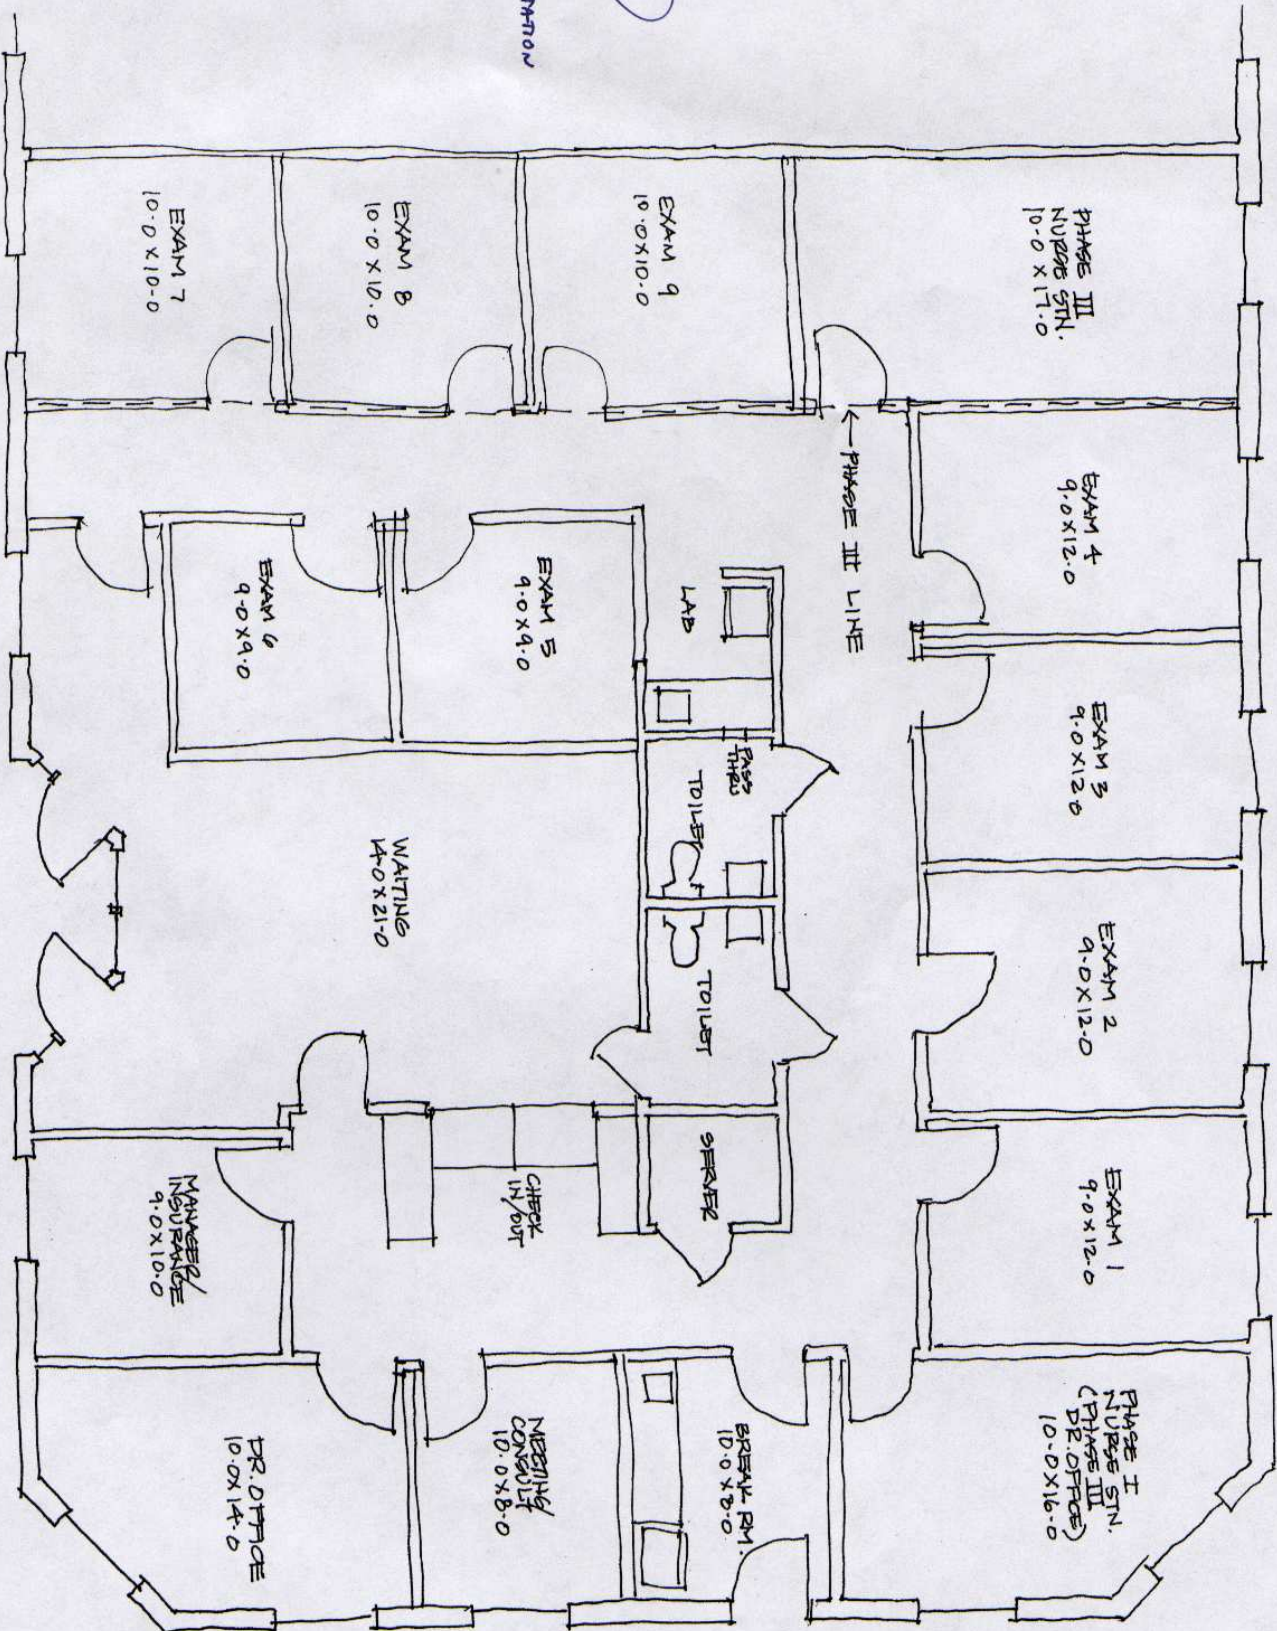

Door on Exam 5?
swap 4 & P.I. Nurses station



FLOOR PLAN 1/4" = 1'-0"
DR. CLEPPER FAITH
SUITE 401 MEADOWLANDS

NOTE: BUILD EXAM ROOMS 4 & 6
AT PHASE I, BUT DON'T FURNISH
AND FIT OUT TIL PHASE III

12-31-08